



**ADDENDUM NO. 2  
TO SPECIFICATIONS AND PLANS FOR THE  
VILLAGE OF GROSSE POINTE SHORES  
COOK ROAD PUMP STATION WATERPROOFING AND WEIR MODIFICATIONS**

**ISSUED:** July 20, 2026

HRC Job No. 20250315

This Addendum is issued prior to receipt of bids to provide for certain changes and clarifications to the Specifications and/or the Drawings, as herein specified, and is hereby made a part of the Contract Documents and shall be taken into consideration in preparing the bids. All other conditions remain the same. **The Bidder shall acknowledge the receipt of this Addendum by writing in the requested Addendum information in the Addenda section on the Bid Form in the Proposal Specification Section 00300.** Failure to acknowledge the Addenda Section of the Bid Form in the submission of the bid may be justification for the bid being rejected as non-responsive

The following lists the extent of this Addendum No. 2. Descriptions of the changes or clarifications are given within the heading.

**DRAWING CHANGES:**

1. **DRAWING S-3 (ISSUED)**
  - a. Adjusted leaders in Proposed Section 1 and included the Relocate Vega Sensor proposal work item in the Repair Miscellaneous Quantities table.

**GENERAL – BIDDER QUESTIONS:**

1. We noticed a SIGNIFICANT presence of insects and termites between the layers of ceiling materials and the concrete inside the station. Any chance the city will have this treated before construction?

**HRC RESPONSE:** The City is not intending to do any removal work to address this issue. The Contractor shall dispose of materials accordingly.

2. Can Sika 641 or 646 be added as an acceptable alternate to the Tremco Roofing?

**HRC RESPONSE:** This alternate will not be considered during the bid phase.







**SUMMARY:**

This Addendum No. 2 has been issued in order to clarify, modify, and add additional items to the original Bid Package. A copy of the amended pages of the Contract Documents noted in Addendum No. 2 herein have been posted online at <http://www.hrcengr.com/bid-info> and on Bid Net Direct (MITN) and must be utilized during the preparation of bids and incorporated into the Bid Documents.

The Bidder shall acknowledge receipt of this Addendum No. 2 in the Proposal Specification Section 00300. Failure of the Bidder to include Addendum No. 2 and its attachments in their bid may result in rejection of the bid.

**End of Addendum No. 2**



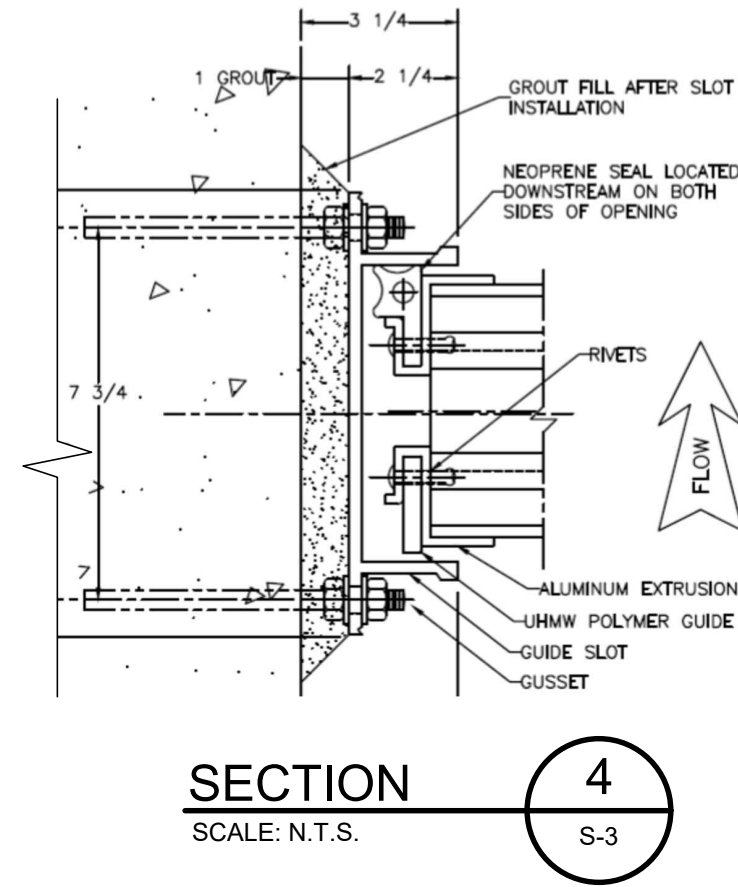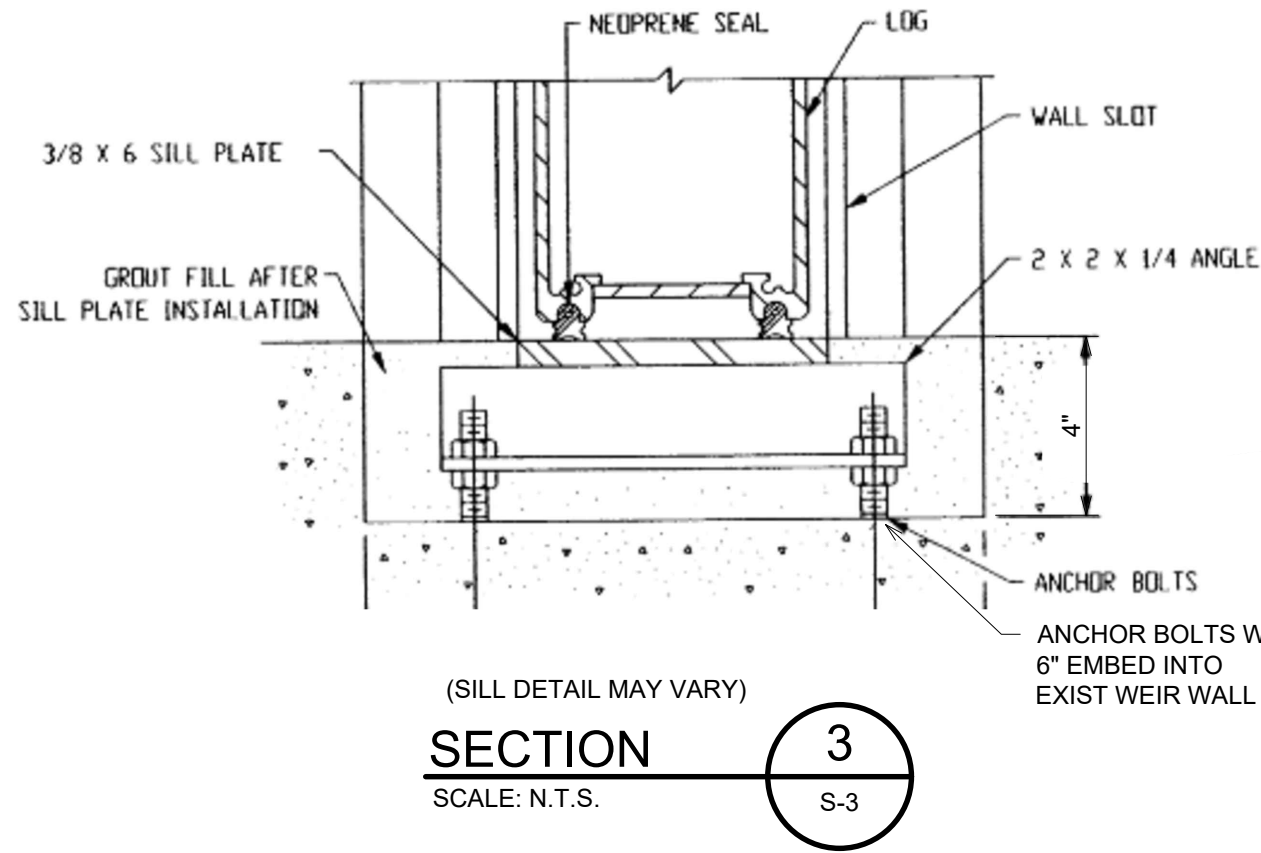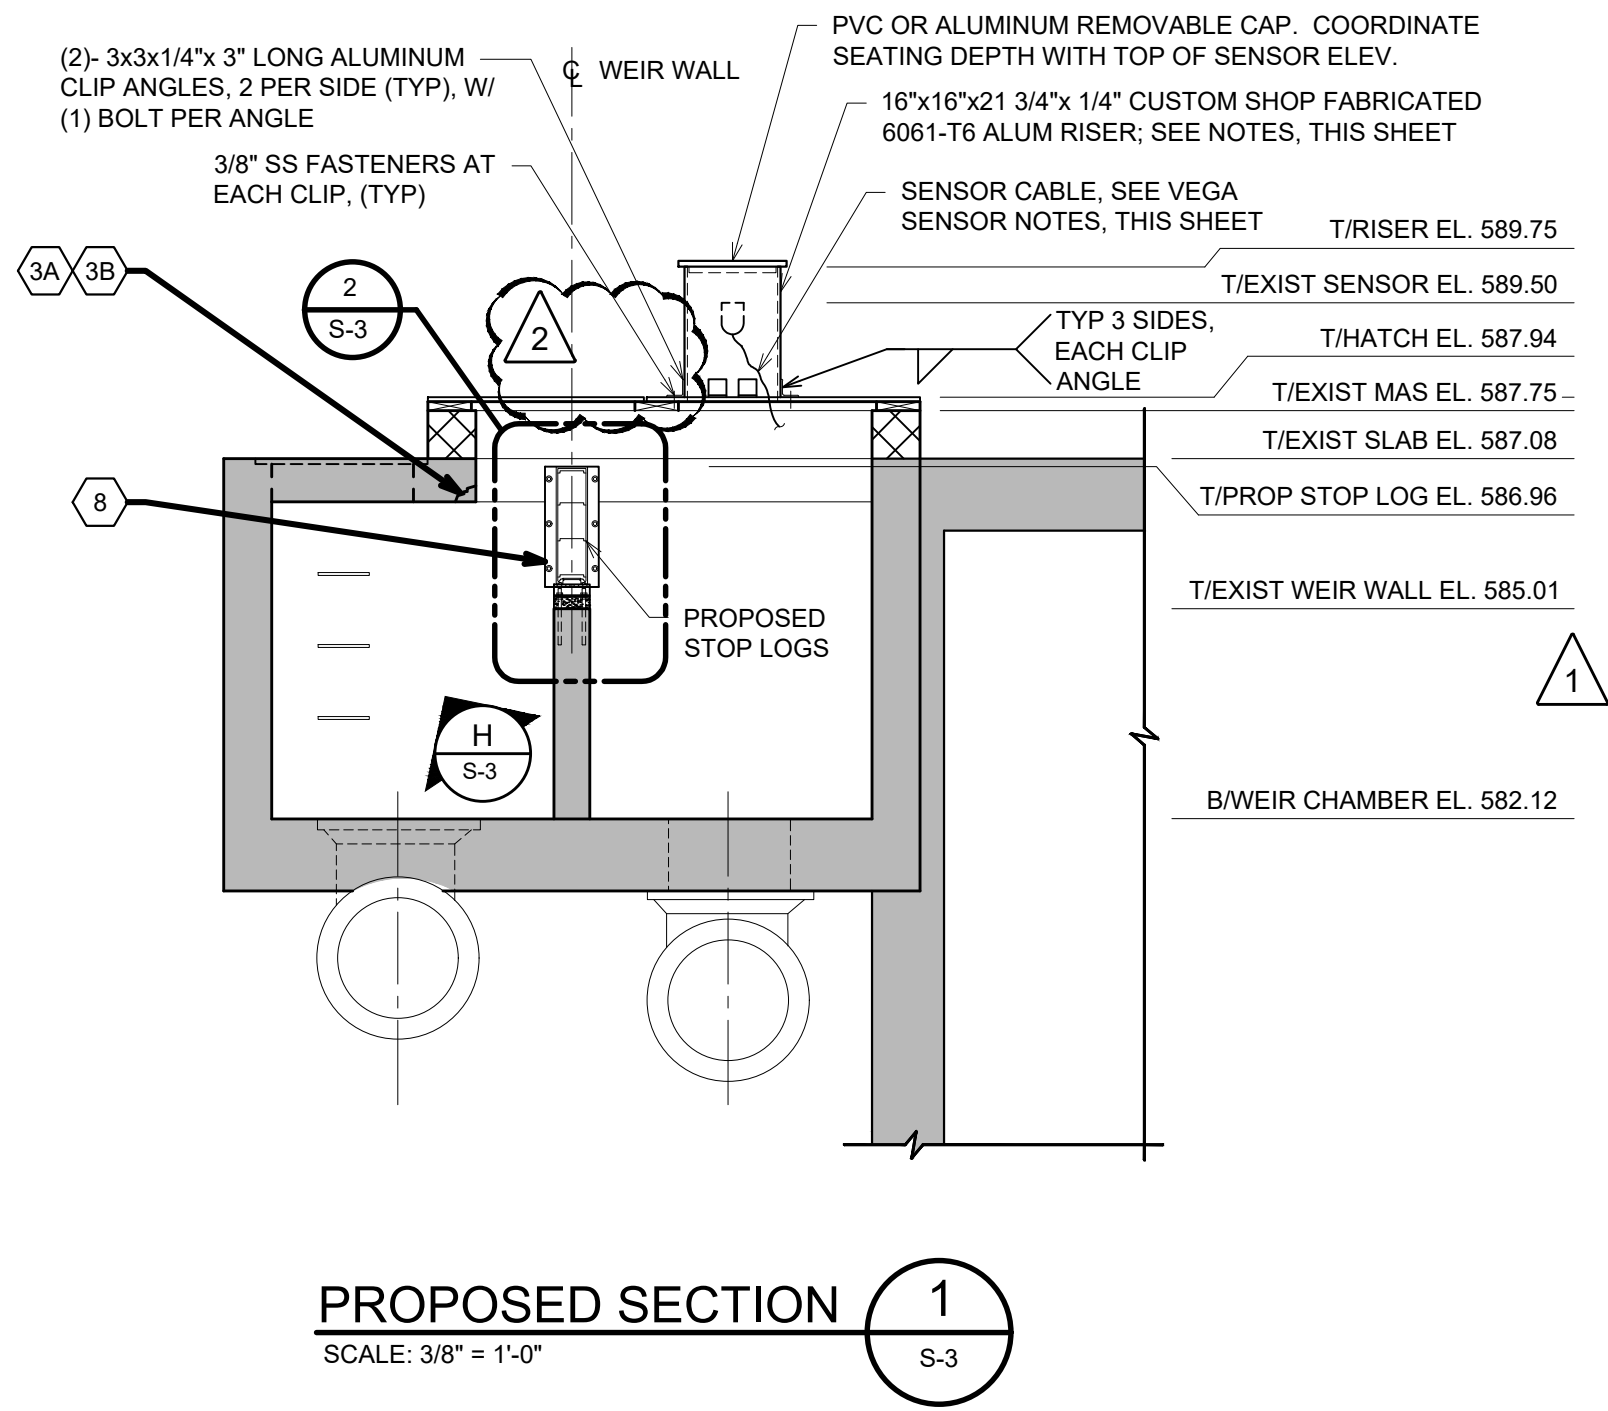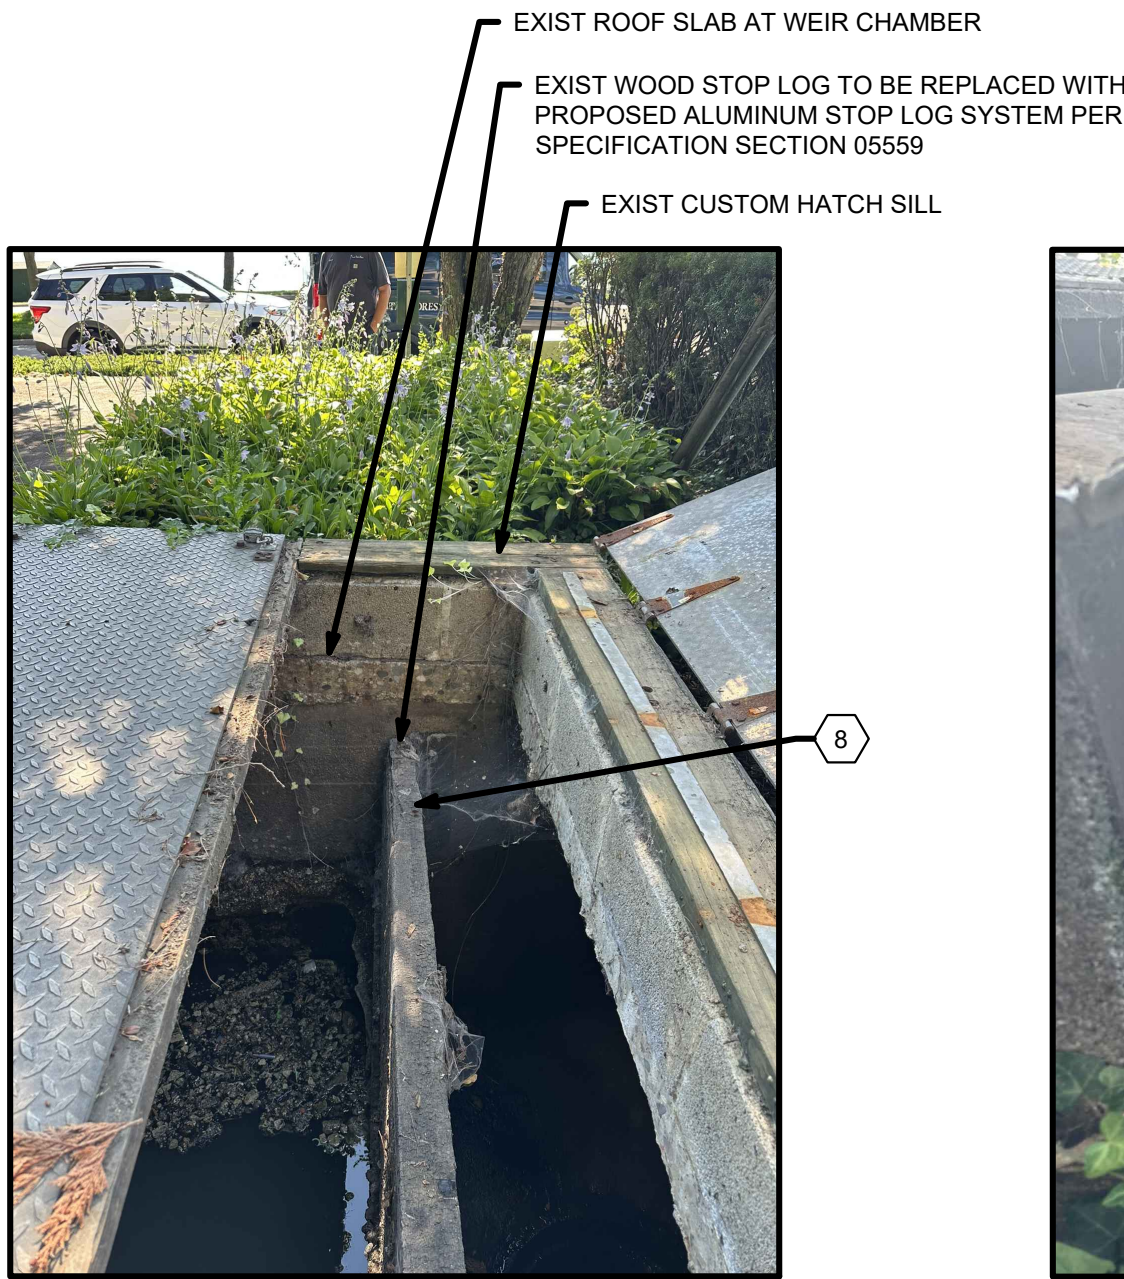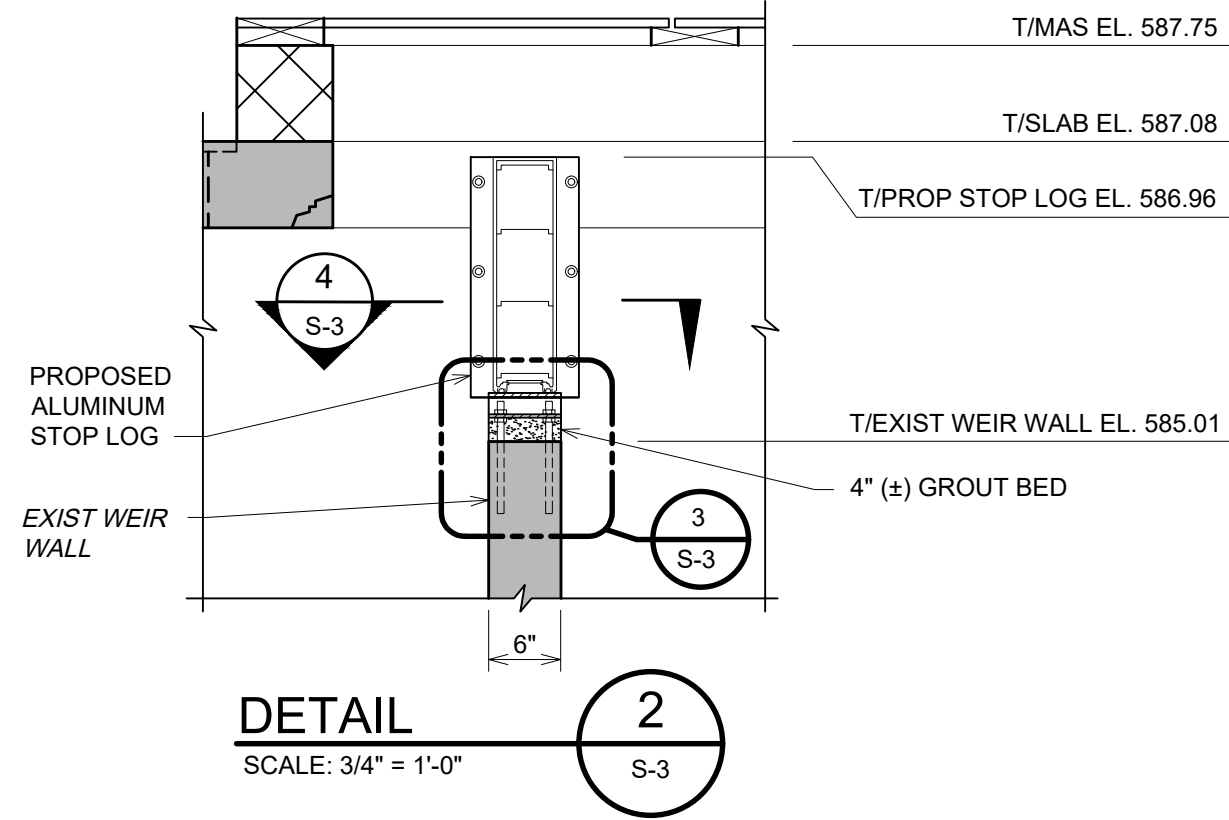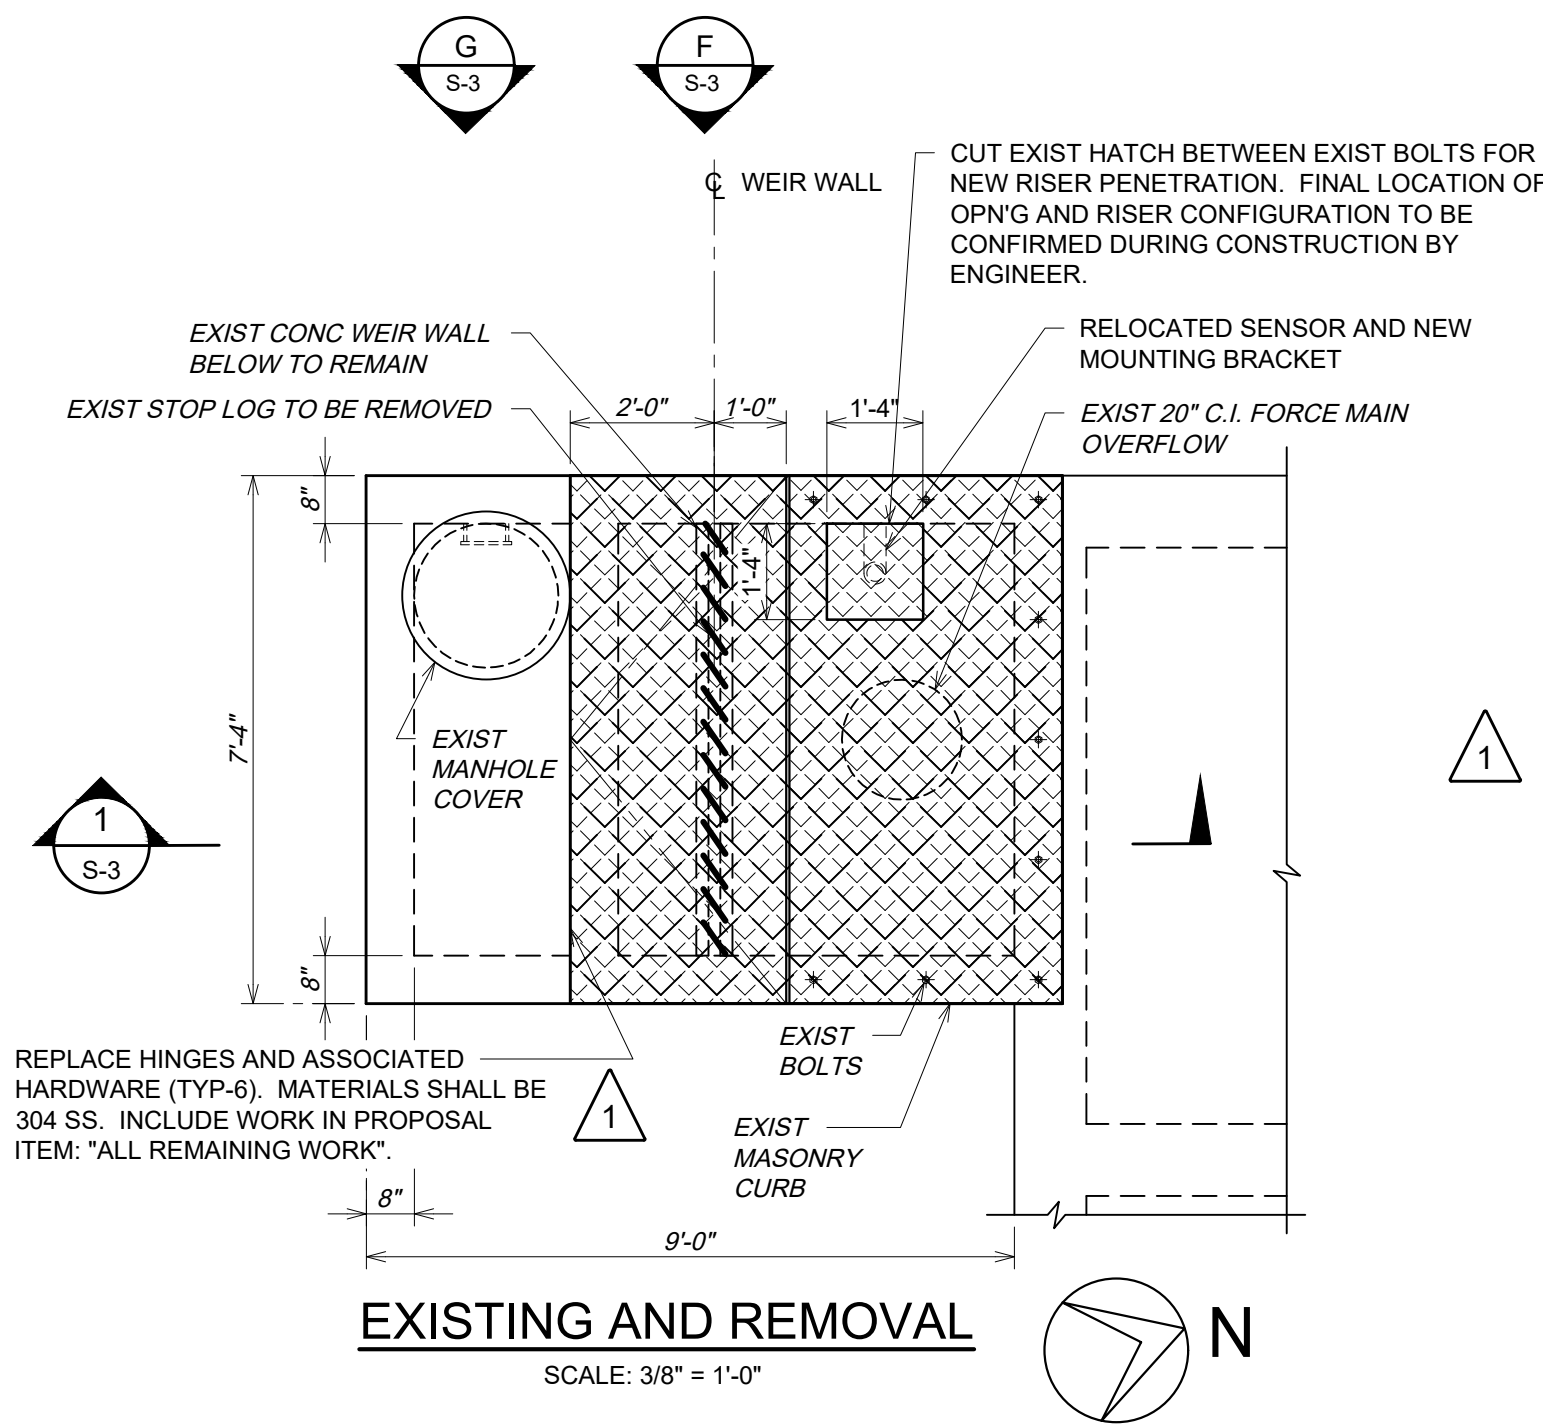

**VEGA SENSOR NOTES:**

- CONTRACTOR TO RELOCATE VEGA SENSOR WITHIN THE WEIR CHAMBER INTO RISER, MOUNTED OFF WEST SIDE OF RISER. SEE PROPOSED SECTION 1 THIS SHEET.
- MOUNT SENSOR IN CENTER OF PROPOSED 16"x16" ALUMINUM RISER USING NEW BRACKET AND HARDWARE. OBTAIN NEW BRACKET AND HARDWARE FROM VEGA.
- BOTTOM OF SENSOR ELEVATION SHALL BE 589.00 FEET.
- RUN CABLE INTO RISER. SLACK IN CABLE MUST BE ENOUGH TO ALLOW HATCH TO OPEN, AND AFFIXED OUT OF SENSOR PATH BY MOUNTING CABLE TO SIDE OF RISER AND UNDERSIDE OF HATCH.



**REPAIR  
MISCELLANEOUS QUANTITIES**

| PROPOSED WORK ITEM DESCRIPTION | UNIT | QUANTITY |
|--------------------------------|------|----------|
| WEIR WALL / STOP LOG - ITEM 8  | LSUM | -        |
| RELOCATE VEGA SENSOR           | LSUM | -        |

**NOTES:**

- THE QUANTITIES FOR THE WORK ITEM DESCRIPTIONS ABOVE ARE APPROXIMATE. CONTRACTOR SHALL BE PAID IN FULL FOR ACTUAL AUTHORIZED AS-CONSTRUCTED AMOUNTS USED ABOVE/BELOW BASE QUANTITY SHOWN. CONTRACTOR TO COMPLETE PRICING SHEET ON THE BID FORM IN SPEC SECTION 00300.
- ANY WORK NOT SPECIFICALLY GIVEN A UNIT QUANTITY DESCRIPTION SHOWN ON THESE SHEETS SHALL BE INCLUDED IN THE LUMP SUM TOTAL PRICE FOR THE PROJECT ON THE BID FORM.

**PROJECT DESCRIPTION:**

THE COOK ROAD PUMP STATION IN THE VILLAGE OF GROSSE POINTE SHORES IS IN NEED OF REPAIR. OVER ALL PROJECT CONSISTS OF LOCALIZED CONCRETE AND MASONRY REPAIRS, REPLACING SKYLIGHTS, RE-COATING THE ROOF SLAB AND RE-COATING THE INTERIOR WALLS AND CEILING OF THE DRY WELL WALLS. THESE REPAIRS ARE INTENDED TO ADDRESS THE INTERIOR WATER DAMAGE AS A RESULT OF WATER LEAKS. ADDITIONALLY, WORK WILL OCCUR WITHIN THE WEIR PORTION OF THE PUMP STATION. NEW STOP LOGS ARE TO BE INSTALLED ATOP OF THE EXISTING WEIR WALL.

**ALUMINUM NOTES:**


- ALUMINUM SHALL BE ASTM B209, ALLOY 6061-T6.
- ALL WELDING AND WORKMANSHIP SHALL CONFORM TO THE FOLLOWING PUBLICATIONS EXCEPT AS SPECIFICALLY INDICATED IN THE CONTRACT DOCUMENTS:
  - AA ADM 1 - ALUMINUM DESIGN MANUAL, LATEST EDITION
  - AMERICAN WELDING SOCIETY (AWS):
    - AWS B5.17 - QUALIFICATION OF WELDING FABRICATORS
    - AWS D1.2 - STRUCTURAL WELDING CODE-ALUMINUM
    - AWS QC 17 - AWS ACCREDITATION OF CERTIFIED WELDING FABRICATORS
- WELDING CERTIFICATION: SUBMIT CERTIFICATION BASED ON AWS B5.17 AND AWS QC 17. QUALIFY PROCEDURES AND PERSONNEL TO THE APPLICABLE AWS CODE. CERTIFY THAT EACH WELDER EMPLOYED ON THE WORK HAS PASSED AWS QUALIFICATION TESTING FOR WELDING PROCESSES INVOLVED WITHIN THE PREVIOUS 12 MONTHS.
- SUBMIT SHOP DRAWINGS FOR REVIEW AND ACCEPTANCE PRIOR TO FABRICATION.
- SHOP WELDED JOINTS SHALL BE COPED AND SMAW.
- PROVIDE CLEAR ANODIZED FINISH TO SHOP FABRICATED RISER PER AA-M10-C22-A31.

**NOTE:**

REFERENCE DRAWINGS ARE FROM PRIOR CONSTRUCTION DOCUMENT SETS FOR THE PUMP STATION AND ARE INCLUDED IN THIS PROJECT FOR REFERENCE ONLY. ELEVATIONS SHOWN ON THE REFERENCE DRAWINGS ARE BASED ON THE NGVD 29 VERTICAL DATUM. PROPOSED ELEVATIONS FOR THIS CONSTRUCTION PROJECT ARE BASED ON THE NAVD 88 VERTICAL DATUM.

THE NAVD88 AND NGVD 29 VERTICAL DATUMS DIFFER BY 0.531 FEET (I.E. NAVD 88 = NGVD 29 - 0.531 FEET).

NO GUARANTEE IS MADE, OR SHOULD BE ASSUMED, AS TO THE COMPLETENESS OR ACCURACY OF THE INFORMATION SHOWN ON THIS DRAWING. PARTIES UTILIZING THIS INFORMATION SHALL FIELD VERIFY THE ACCURACY AND COMPLETENESS PRIOR TO CONSTRUCTION ACTIVITIES.

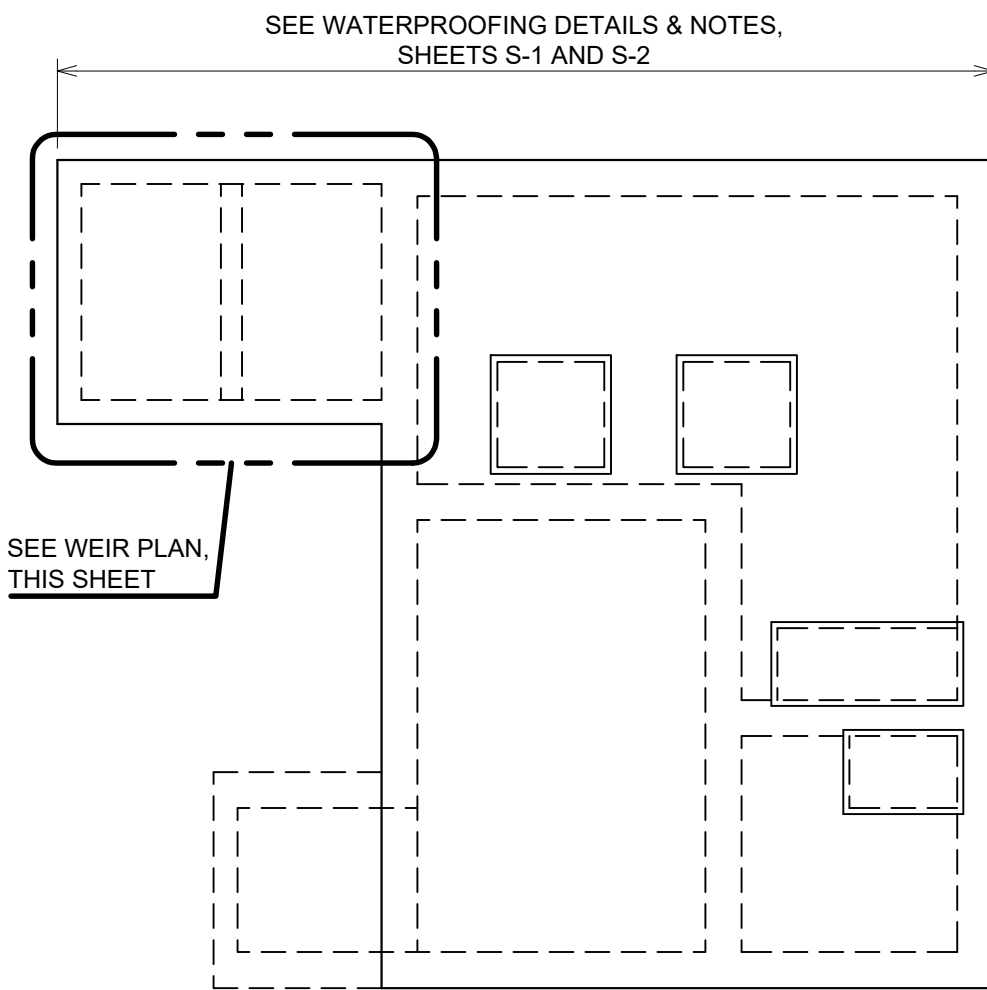

**HRC**  
**HUBBELL, ROTH & CLARK, INC**  
CONSULTING ENGINEERS SINCE 1915  
555 HULET DRIVE  
BLOOMFIELD HILLS, MICH. P.O. BOX 824  
48303 - 0824  
PHONE: (248) 454-6300  
FAX (1st Floor): (248) 454-6312  
FAX (2nd Floor): (248) 454-6359  
WEB SITE: www.hrcengr.com

| DATE       | ADDITIONS AND/OR REVISIONS |
|------------|----------------------------|
| 07-20-2026 | ADDENDUM NO. 2             |
| 07-14-2026 | ADDENDUM NO. 1             |
| 06-16-2026 | ISSUED FOR BIDS            |
| 06-01-2026 | 100% OWNER REVIEW          |
| 03-20-2026 | ISSUED FOR PART 41 PERMIT  |
| DESIGNED   | NDW                        |
| DRAWN      | PMH                        |
| CHECKED    | NDW                        |
| APPROVED   |                            |



**VILLAGE OF GROSSE POINTE SHORES,  
A MICHIGAN CITY**  
**COOK ROAD PUMP STATION  
WATERPROOFING  
AND WEIR MODIFICATIONS**

WEIR WALL/ STOP LOG  
DETAILS AND NOTES

|                         |                     |
|-------------------------|---------------------|
| HRC JOB NO.<br>20250315 | SCALE<br>AS NOTED   |
| DATE<br>July 2026       | SHEET NO.<br>S-3 OF |